




RACK ID:
PDX2-NWR-R301

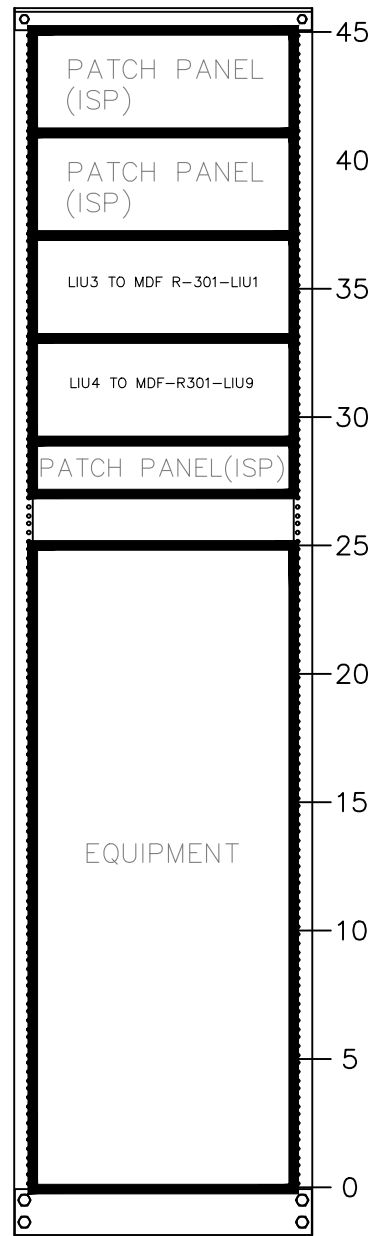


RACK ID:
PDX2-NWR-R303

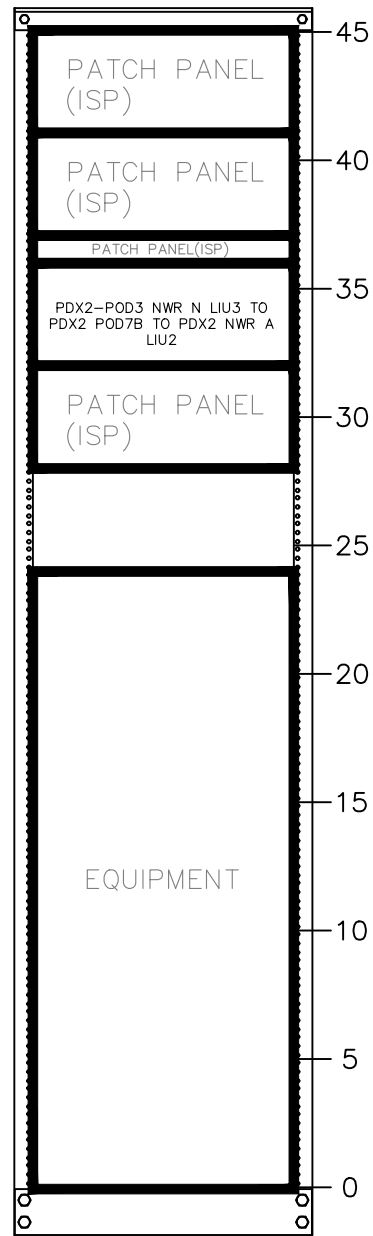


RACK ID:
PDX2-NWR-R304

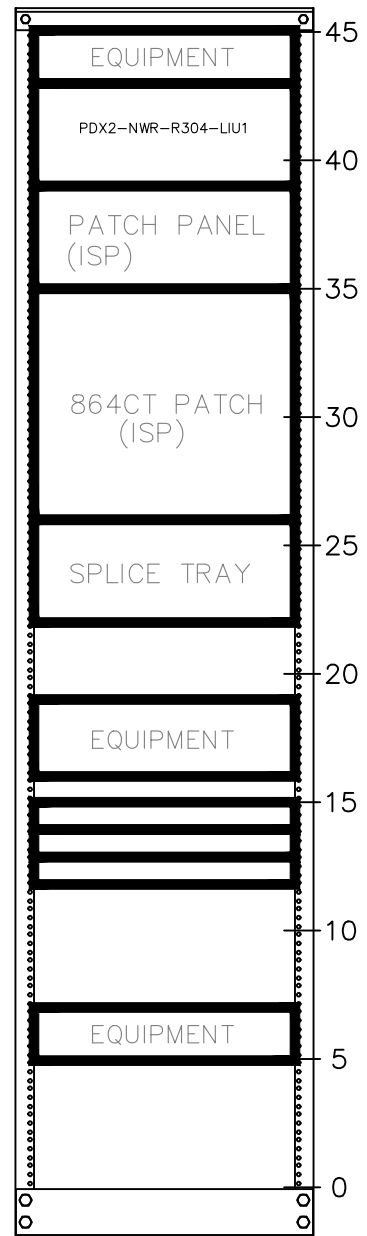

RACK ID:
PDX2-NWR-R305

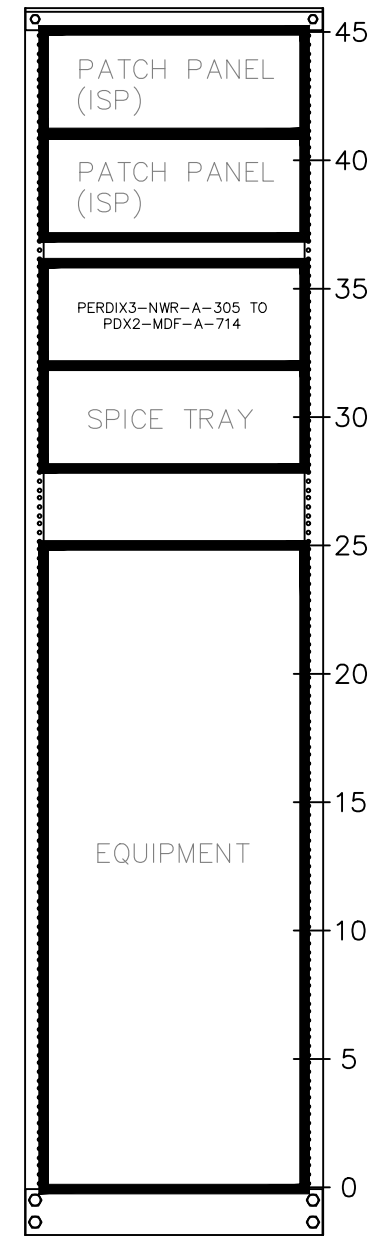

PDX2 - PERDIX3 - NWR - SIDE A - RACKS 301,303,304,305

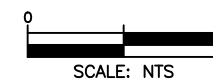

3				AS-BUILT
2	1/10/2017	JLS	JLS	REVISION # 1
1	7/13/16	JLS	JLS	ORIGINAL
NO.	DATE	ENGINEER	DRAFTER	COMMENT



AMAZON PM:	JOHN LANGLEY
ENGINEERING FIRM:	MGC TECHNICAL CONSULTING INC.
PROJECT NUMBER:	N/A
LOCATION:	BEACH ACCESS ROAD UMATILLA, OR 97882
DRAWING NAME:	AMAZON - PDX2 - ASBUILT (1.5.17).dwg
CONFIDENTIAL/PROPRIETARY	SHEET: 56 OF 66